



329 B EAST OXFORD ST.
 PONTOTOC, MS 38863
 662-200-2564 FAX 662-200-2587

www.flagstarconstruction.com


Transmittal

To: Dale Bailey an Association Date: 0822/2022
 One Jackson Place 250, 188 East Capital Street Attn: Paul Purser, Architect, AIA, NCARB,
 Jackson, MS 39201 LEED AP BD+C

Re: SUBMITTAL 038 CC:
 PN: 21064, Pontotoc City Schools ESSER 2&3

WE ARE SENDING YOU ATTACHED:

Shop Drawings Prints/Plans Specifications Copy of Letter Samples Other:

COPIES	SECTION	DESCRIPTION
1	Division 05	Jr. High School ADA Ramp Hand Rails
		Handrail Shop Drawings
<div style="border: 1px solid black; padding: 5px;"> <input type="checkbox"/> Reviewed <input checked="" type="checkbox"/> Reviewed As Noted <input type="checkbox"/> Reviewed, Not Approved <input type="checkbox"/> Revise & Resubmit Reviewed for the limited purpose of checking for conformance with information given and the design concept expressed in the Contract Documents. This review was not conducted for the purpose of determining the accuracy and completeness of other quantities or for substantiating instructions for installation, assembly, performance of materials, equipment, systems, or construction means and methods - all of which remain the responsibility of the Contractor. Dale Partners Architects, P.A. By:  Date: 8/24/22 </div>		

THESE ARE TRANSMITTED FOR THE FOLLOWING ACTION:

- For Approval For Your Use As Requested For Review For Bid Due:
 Approved as Submitted Approved as Noted Returned for Corrections/Resubmittals
 Resubmit copies for approval Return corrected sets

Remarks:

From: Mike Parker

Received by: _____


PAUL BOX
196 STRONG ROAD
CANTON, MS 39046

LETTER OF TRANSMITTAL

DATE	8-22-22	JOB NO.	9036
ATTENTION	MIKE		
REF.			
PONTOTOC CITY SCHOOLS			
UPPER SITE RAMP			

TO STEELWORKS LLC
5217 GREENWAY DR. EXT.
JACKSON, MS. 39204

WE ARE SENDING YOU ATTACHED UNDER SEPARATE COVER VIA E-MAIL THE FOLLOWING ITEMS:
 SHOP DRAWINGS PRINTS PLANS SAMPLES CHANGE ORDER
 COPY OF LETTER ORIGINALS INVOICE ENCLOSED _____

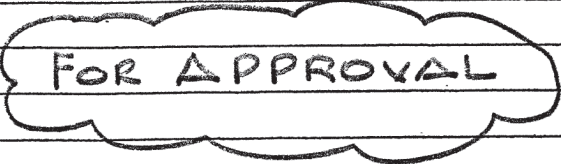QTY	ORIG/COPY	DESCRIPTION
1		E5, E6, 14 THRU 24.
		

THESE ARE TRANSMITTED AS CHECKED BELOW:

- | | | |
|--|---|---|
| <input checked="" type="checkbox"/> FOR APPROVAL (1ST) | <input type="checkbox"/> REVISED DRAWINGS | <input type="checkbox"/> FOR REVIEW AND COMMENT |
| <input type="checkbox"/> FOR APPROVAL (2ND) | <input type="checkbox"/> AS REQUESTED | <input type="checkbox"/> RETURNED FOR CORRECTIONS |
| <input type="checkbox"/> READY FOR SHOP | <input type="checkbox"/> FOR YOUR USE | <input type="checkbox"/> BID SET |
| <input type="checkbox"/> FILE & FIELD DRAWINGS | <input type="checkbox"/> _____ | |

REMARKS E-MAIL THIS DATE TO:

PAUL BOX DETAILING @ COMCAST. NET
MIKE @ STEELWORKS LLC. COM

COPY TO _____





























SIGNED _____

PAUL BOX

NORTH



IS H.R. READ HERE IF SO FURNISH DIM.

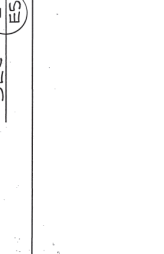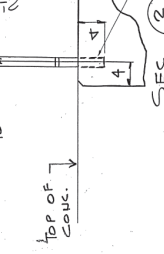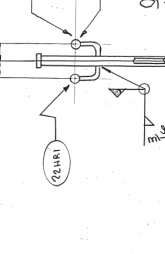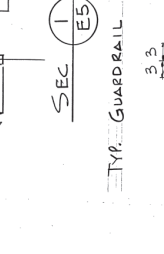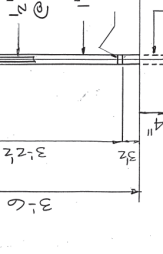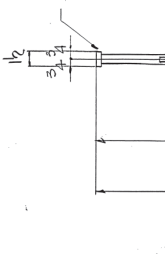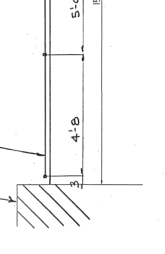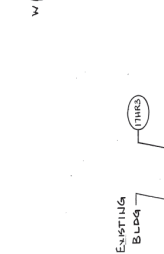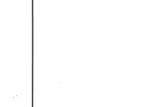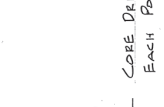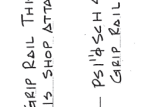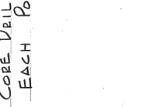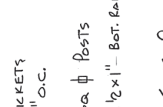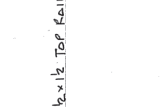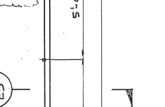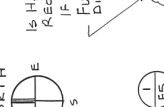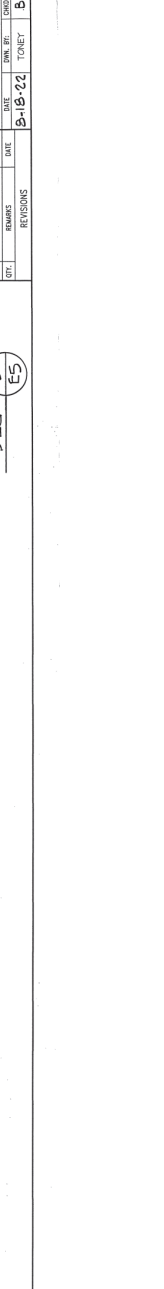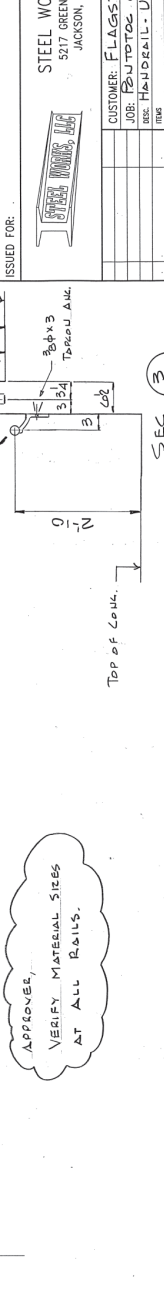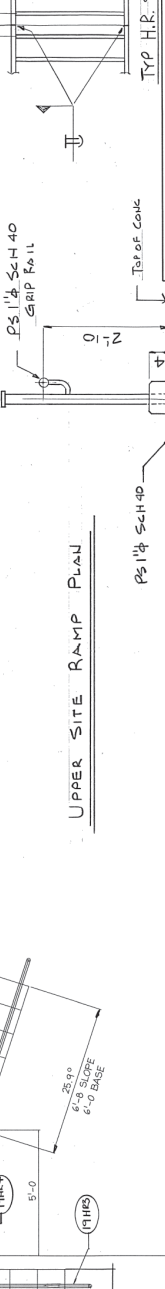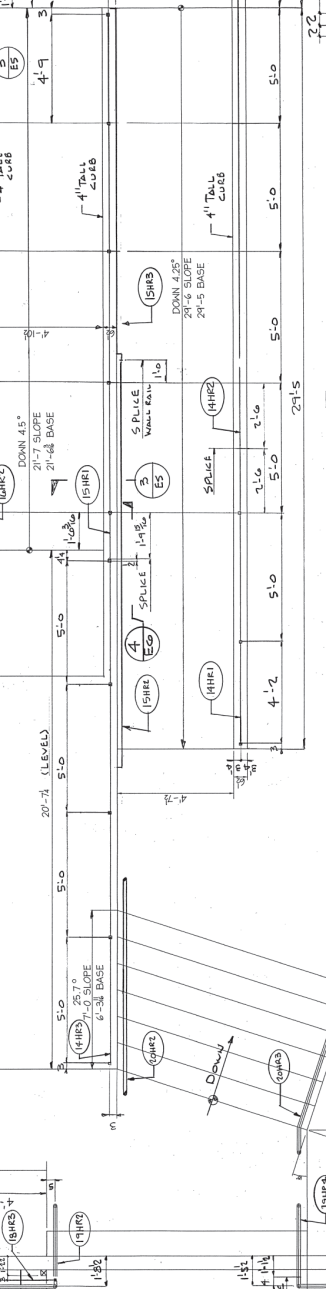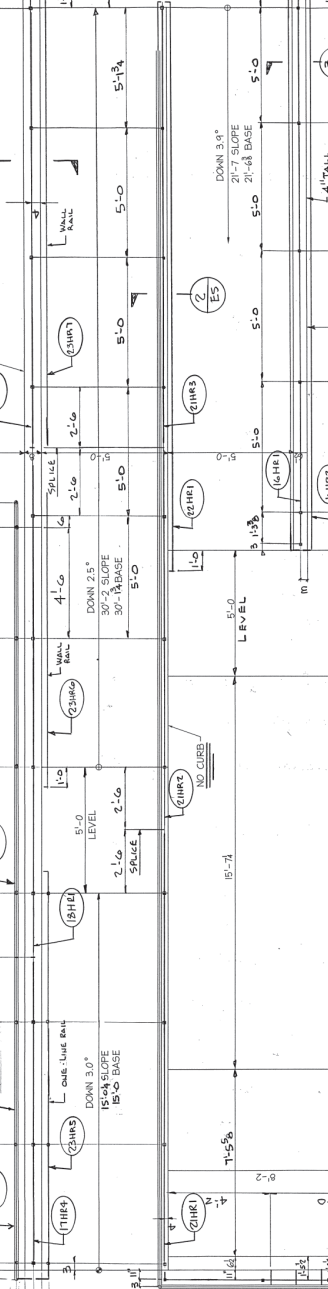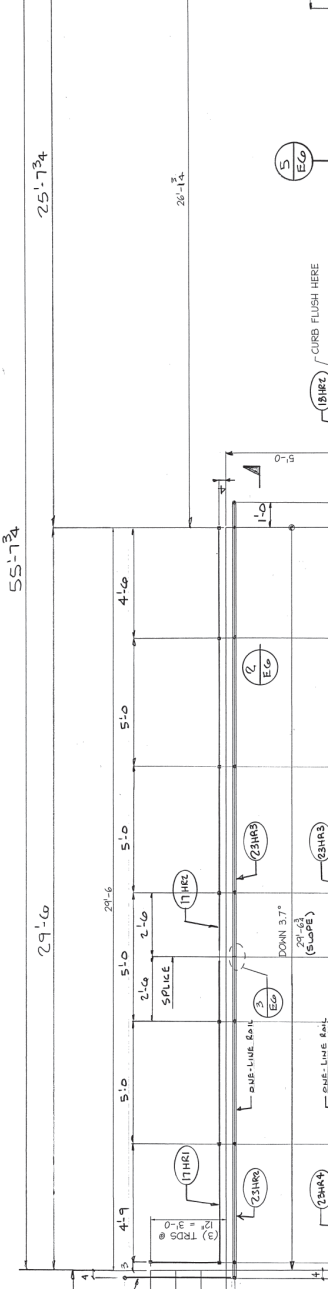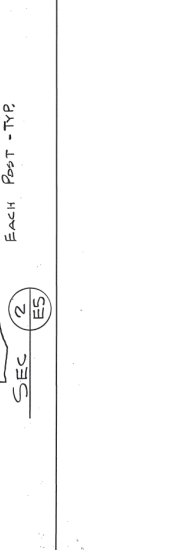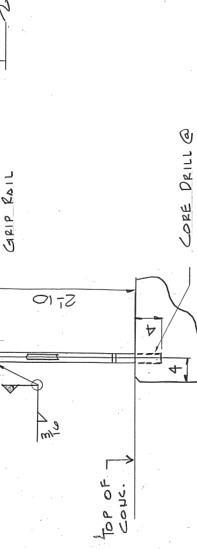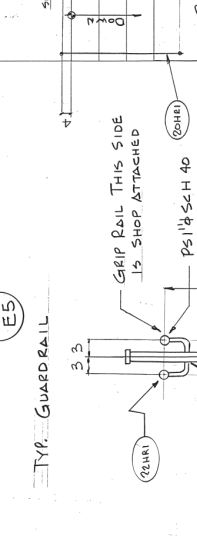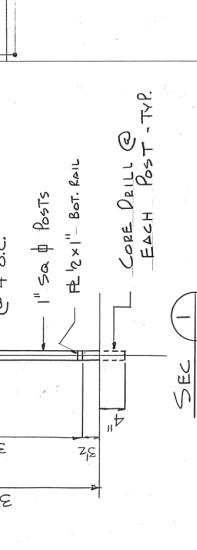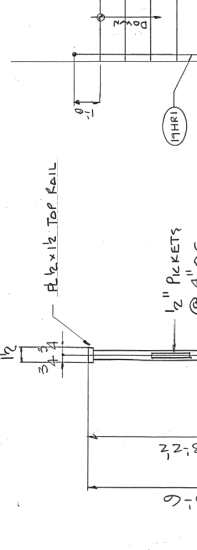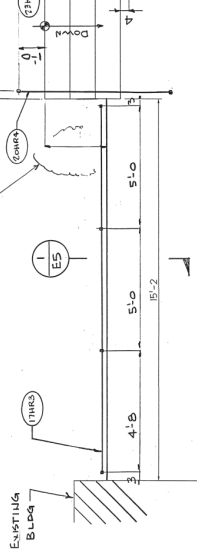

APPROVE, VERIFY MATERIAL SIZES AT ALL RAILS.

UPPER SITE RAMP PLAN









DATE	
REVISIONS	
REV.	DESCRIPTION
1	
2	
ISSUED FOR:

STEEL WORKS, L.L.C.
5217 GREENWAY DRIVE
JACKSON, MS 39242

CUSTOMER: FLAGSTAR CONST.
JOB: BENTON CITY SCHOOLS
DESC: HANDRAIL - UPPER SITE RAMP

DATE: 08/13/2013
DRAWN BY: J.B. BROWN
CHECKED BY: J.B. BROWN
DATE: 08/13/2013
SCALE: AS SHOWN
JOB NO: 10336
TOWER: B-18-20
REVISED BY: J.B. BROWN

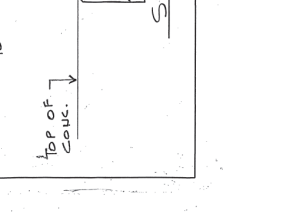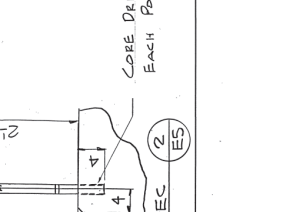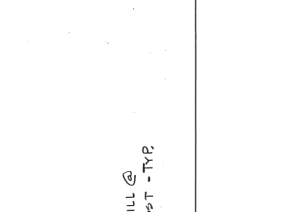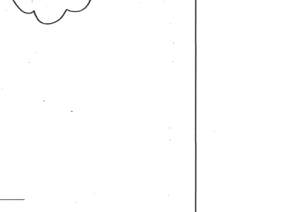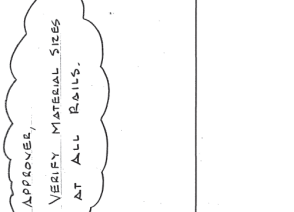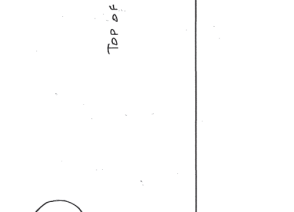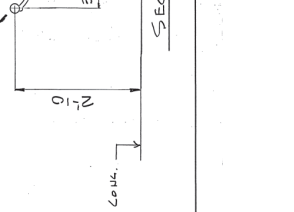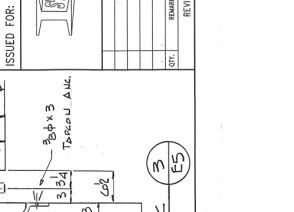






JOB NO. 9036
DRAWING NO. EGO


PROJECT: POUTOOC CITY SCHOOLS
LOCATION: POUTOOC, MS
MATERIAL FOR: HANDRAIL UPPER-SITE RAMP & STAIRS
DRAWN BY: DOX
CHECKED BY: D. TONEY

CONTRACTOR: FLAGSTAR CONST.
ARCHITECT: DALE BAILEY - BA ASSOC.
REVISIONS

NOTE - IMPORTANT - NOTE
WE WILL NOT ACCEPT BACK CHARGES FOR LABOR, MATERIALS, OR CORRECTIVE WORK UNLESS AUTHORIZED IN WRITING BY OUR OFFICE

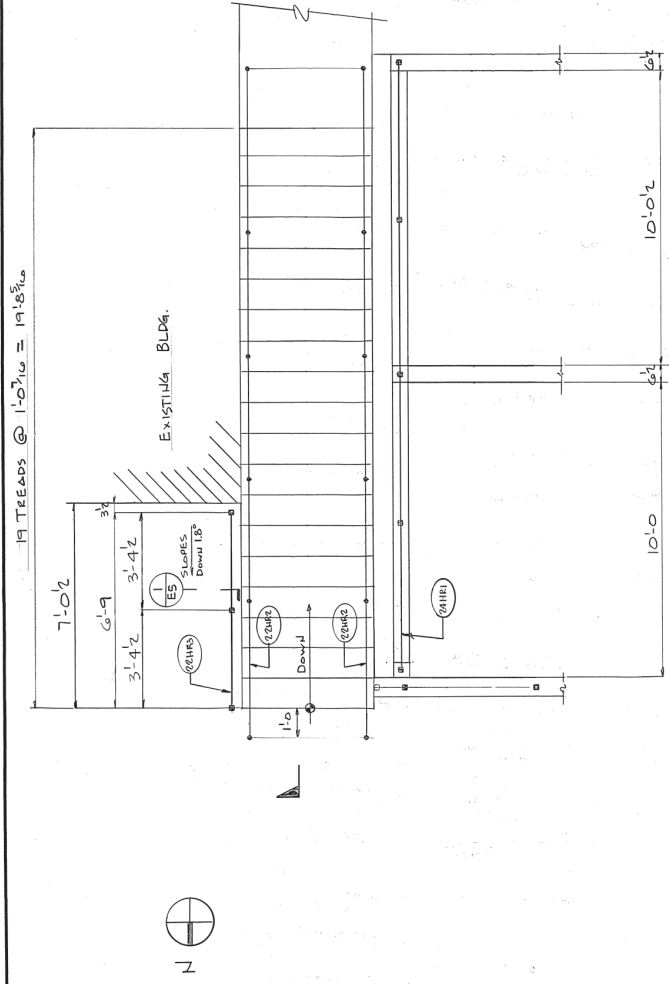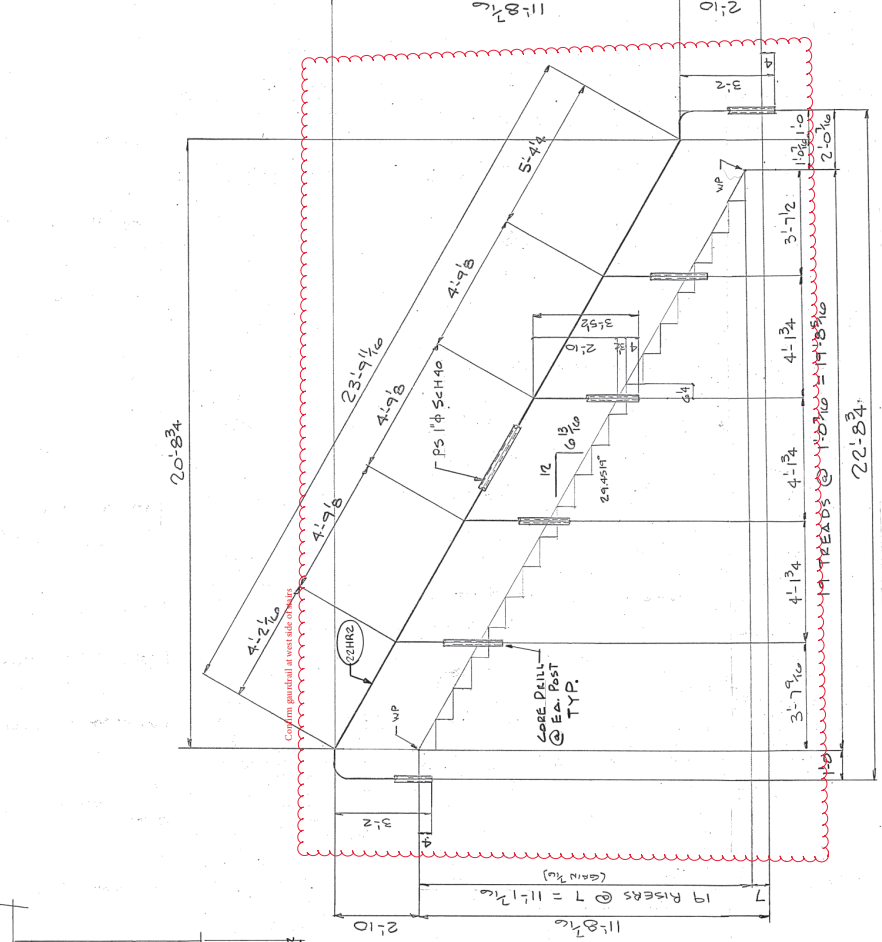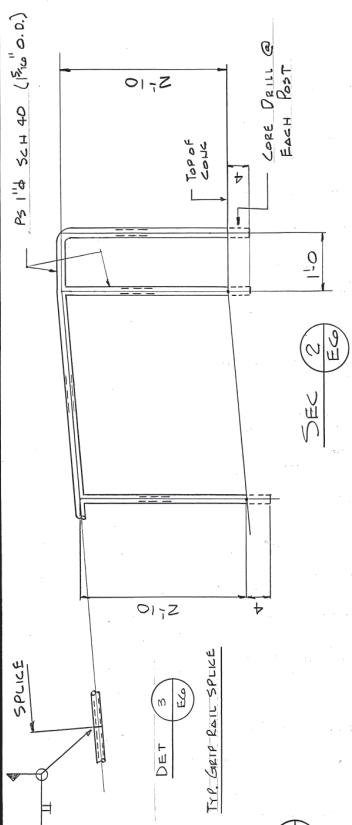

PARTIAL PLAN @ EAST STAIR

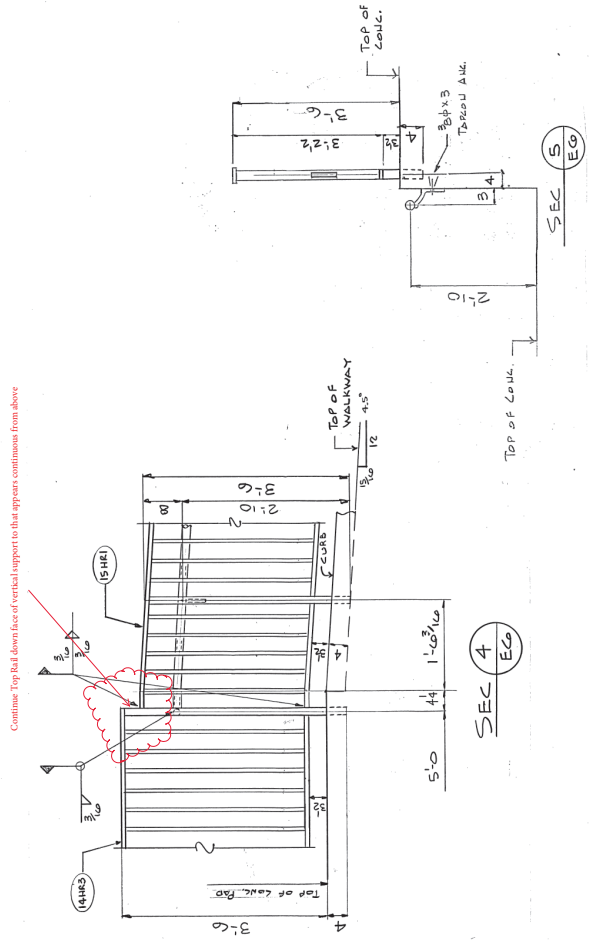

SEC 4 EGO

SEC 5 EGO

SEC 1 EGO

SEC 2 EGO

SEC 3 EGO

SEC 100 EGO

SHOP BILL

NO.	DESCRIPTION	ASSEMBLY	LENGTH FT. IN.	MARK	SHIPPING MARK	REMARKS	WEIGHT
1	HANDRAIL	M14	12 1/2	M14	14HR1		
2	"	M14	11	M14			
3	"	M14	90	M14			
4	"	M14	10	M14			
5	"	M14	12 1/2	M14			
6	"	M14	12 1/2	M14			
REVISIONS

NO.	DATE	DESCRIPTION

FIELD NOTES

DATE: 8/22
 BY: [Signature]
 CHECKED: D.T.
 DATE: 8/22


PROJECT: STRUCTURAL & MISCELLANEOUS ERECTION
CUSTOMER: FLAGSTAR CONST.
PROJECT: HANDBAIL - UPPER SITE RAMP
DATE: 8/22
CHECKED: D.T.
DATE: 8/22

MATERIALS:
 PRIMER: [Blank]
 PAINT: [Blank]


SHOP ORDER: 9030

SHEET: 14


REFERENCE ERECTION PLANS: ONE 14HR1

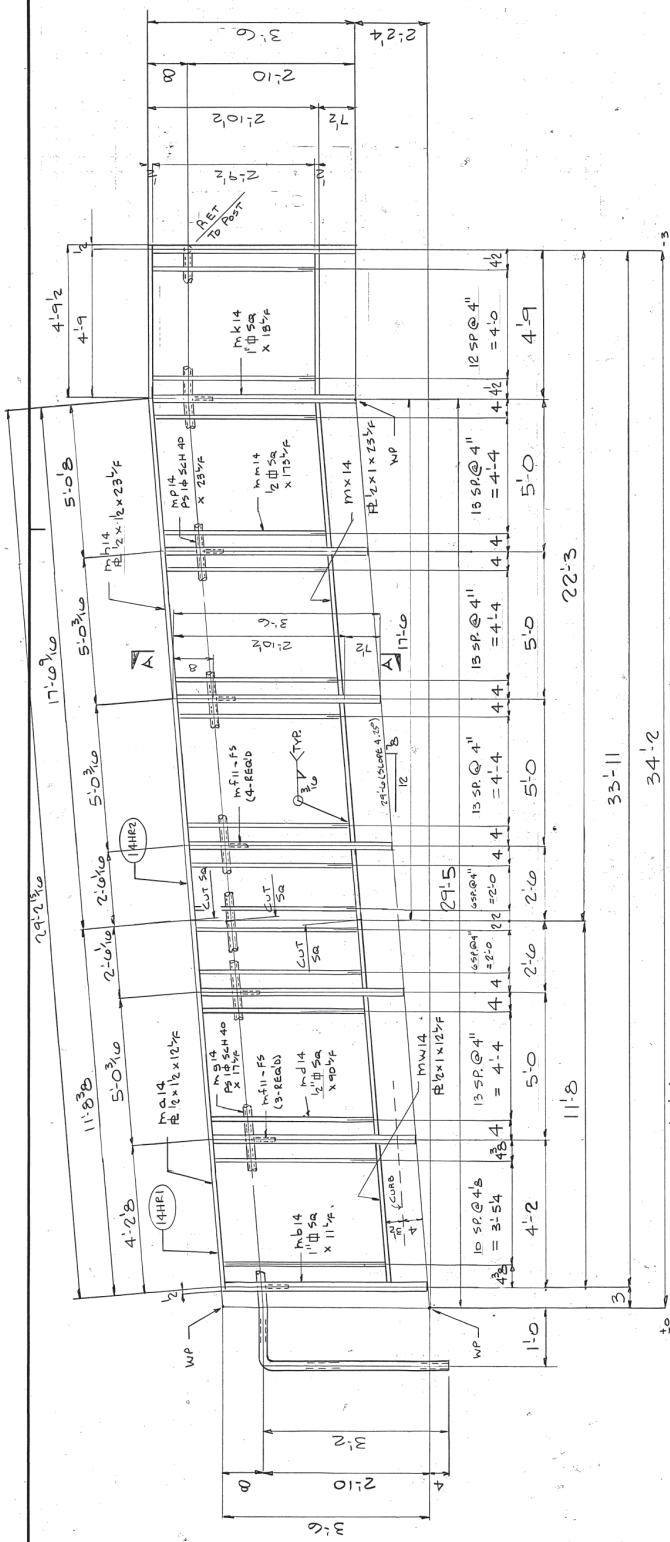

ONE 14HR1

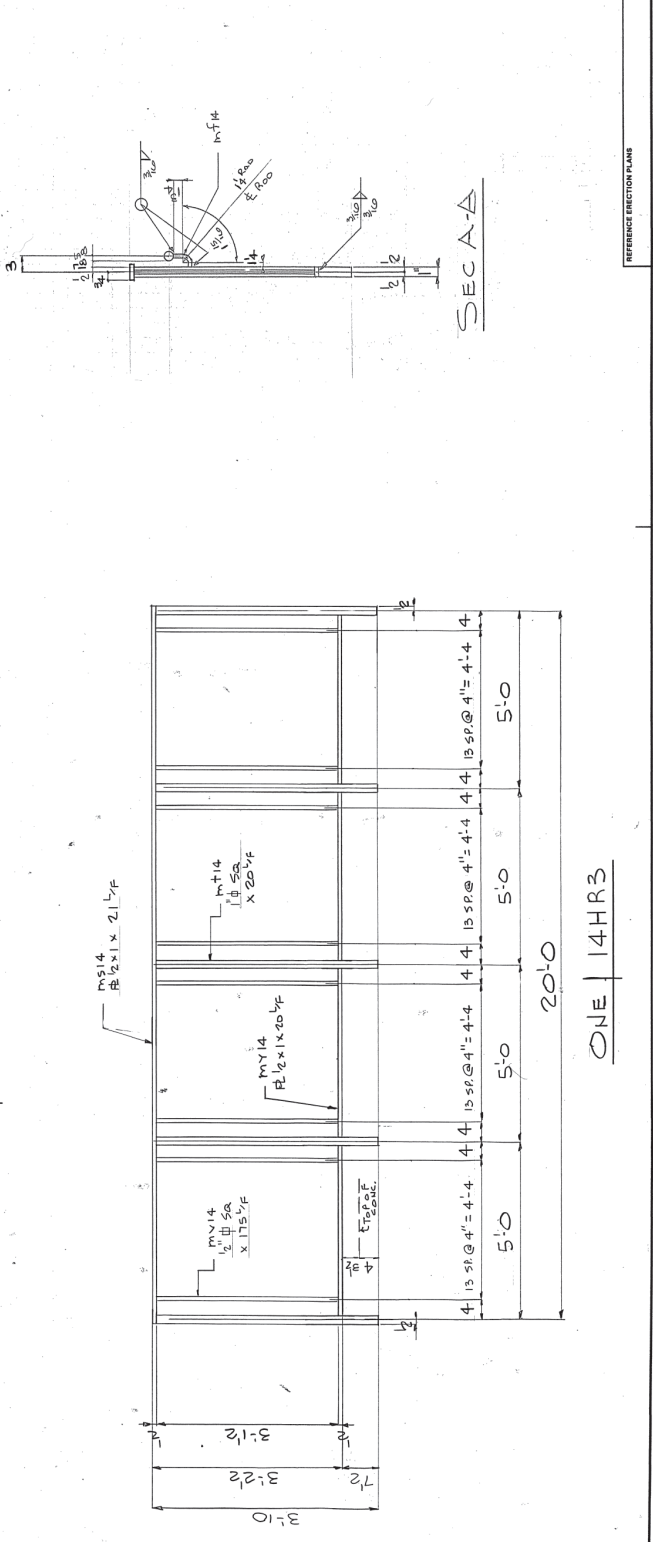

ONE 14HR3

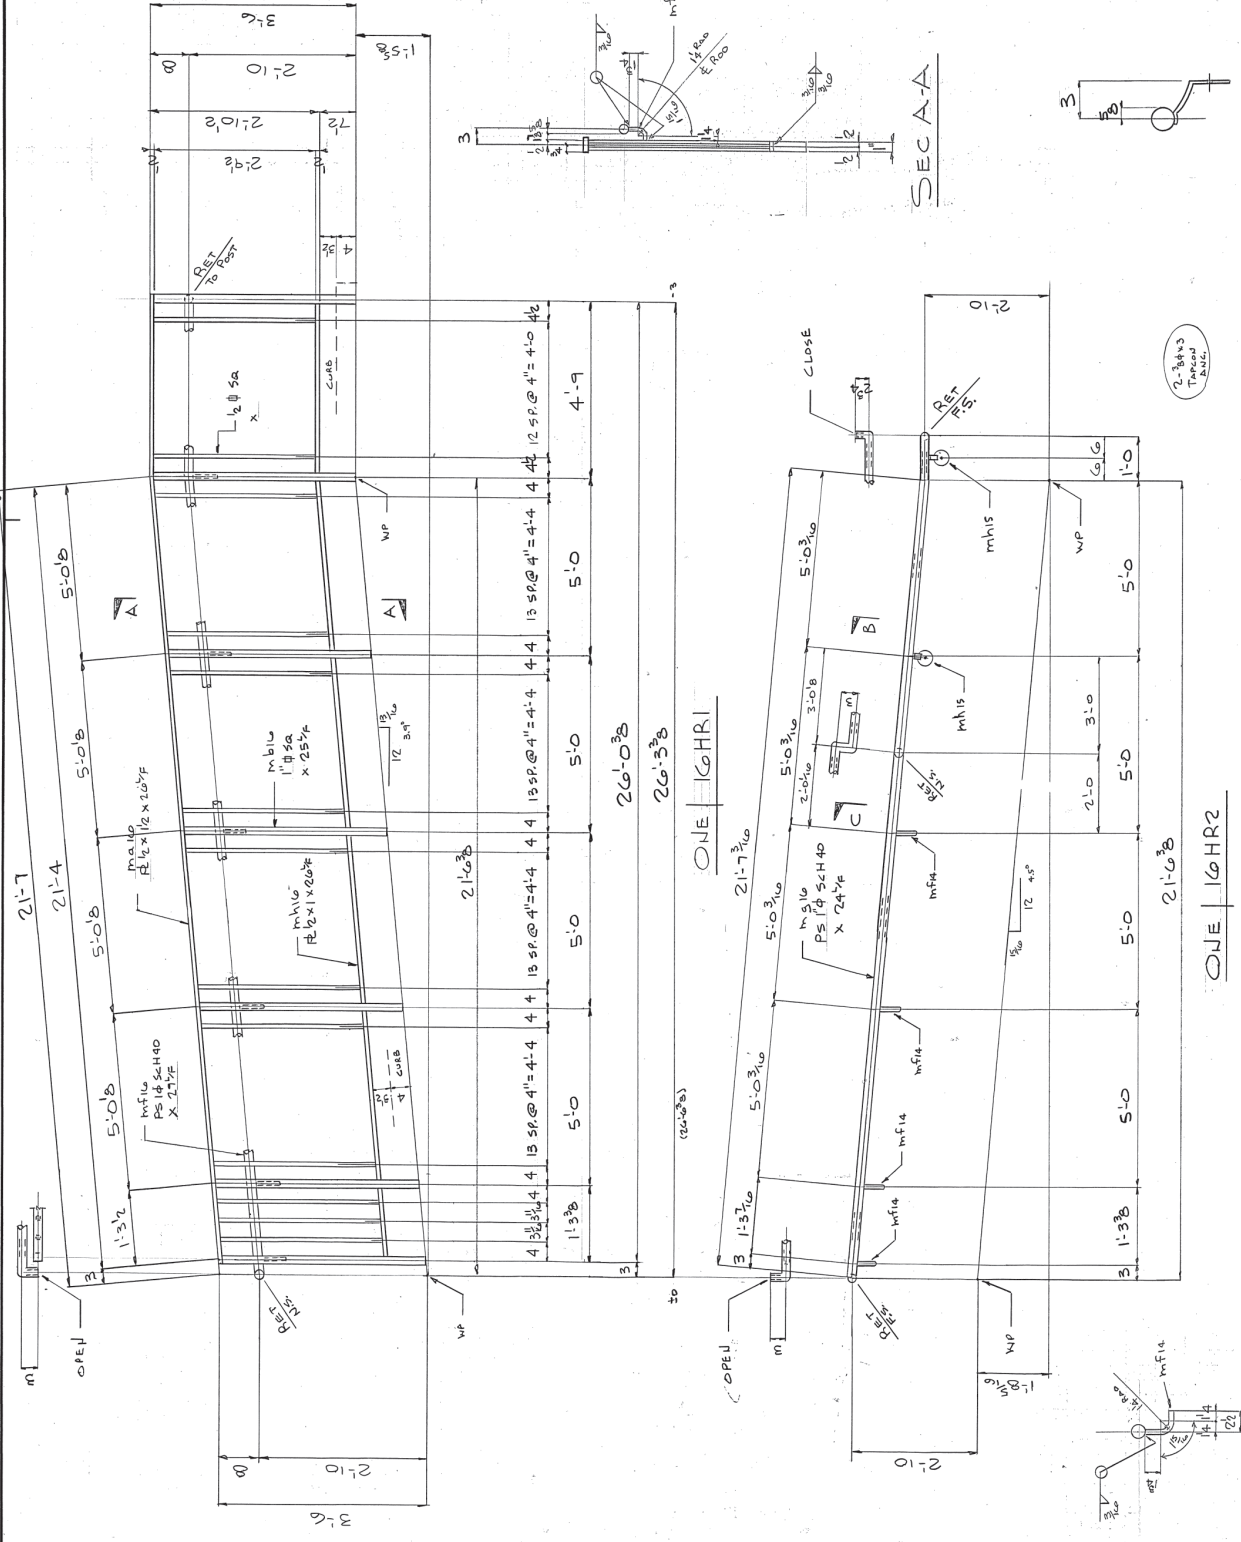

NO.	DESCRIPTION	ASSEM.	LENGTH	MARK	SHIPPING	REMARKS	WEIGHT
			FT. IN.		MARK		
1	HANDRAIL		21		16HR1		
1	1/2" x 1/2"		25		m.f.10		
1	1/2" x 1/2"		25		m.f.11		
1	1/2" x 1/2"		25		m.f.12		
1	1/2" x 1/2"		25		m.f.100		

PROJECT: **POHITOC CITY SCHOOLS**
 CUSTOMER: **FLAGSTAR CONST.**
 DETAIL: **HANDRAIL - UPPER SITE RAMP**
 DRAWING NO.: **9036**
 CHECKED BY: **DATE 8/2/22**
 SHOP ORDER: **10**
 SHEET: **10**





SHOP BILL

NO.	DESCRIPTION	LENGTH FT. IN.	ASSEMBLY MARK	SHIPPING MARK	REMARKS	WEIGHT
1	HAUDRAIL R 1/2 x 1 1/2	15 1/2	M317	T1HR2		
1	1" x 1/2 SA	60	M317			
1	1" x 1/2 SA	60	M317			
1	R 1/2 x 1 1/2	15 1/2	M317			
1	HAUDRAIL R 1/2 x 1 1/2	15 1/2	M317	T1HR2		
1	1" x 1/2 SA	60	M317			
1	1" x 1/2 SA	60	M317			
1	R 1/2 x 1 1/2	15 1/2	M317			
1	HAUDRAIL R 1/2 x 1 1/2	15 1/2	M317	T1HR3		
1	1" x 1/2 SA	60	M317			
1	1" x 1/2 SA	60	M317			
1	R 1/2 x 1 1/2	15 1/2	M317			
1	HAUDRAIL R 1/2 x 1 1/2	15 1/2	M317	T1HR4		
1	1" x 1/2 SA	60	M317			
1	1" x 1/2 SA	60	M317			
1	R 1/2 x 1 1/2	15 1/2	M317			

REVISIONS	DATE	DESCRIPTION
1	10/11/22	FIELD BOLT SUMMARY THIS SHEET
2	10/11/22	FIELD BOLT SUMMARY THIS SHEET
3	10/11/22	FIELD BOLT SUMMARY THIS SHEET

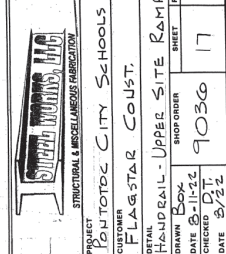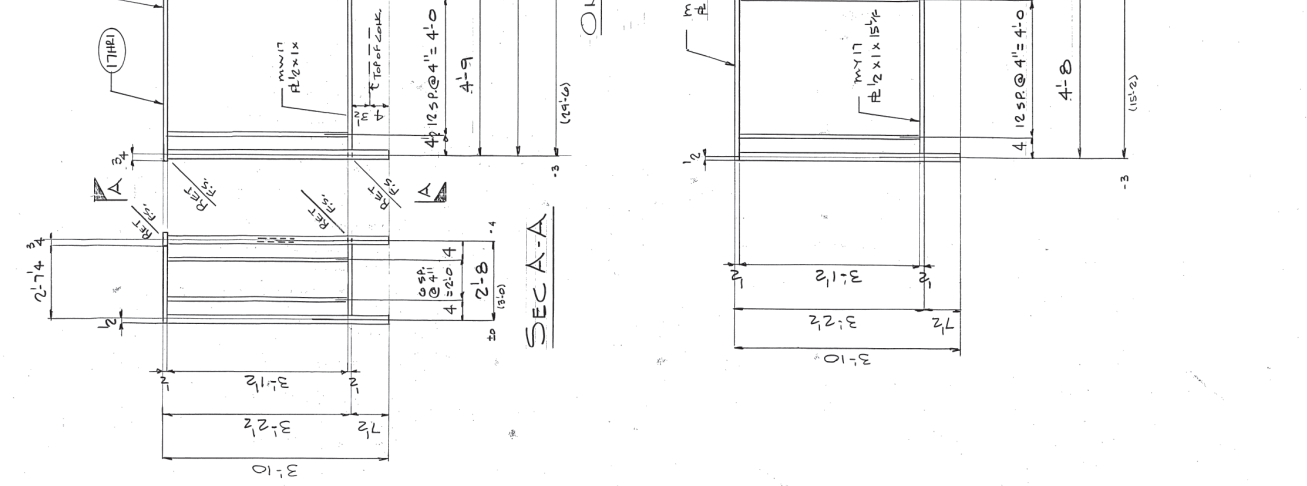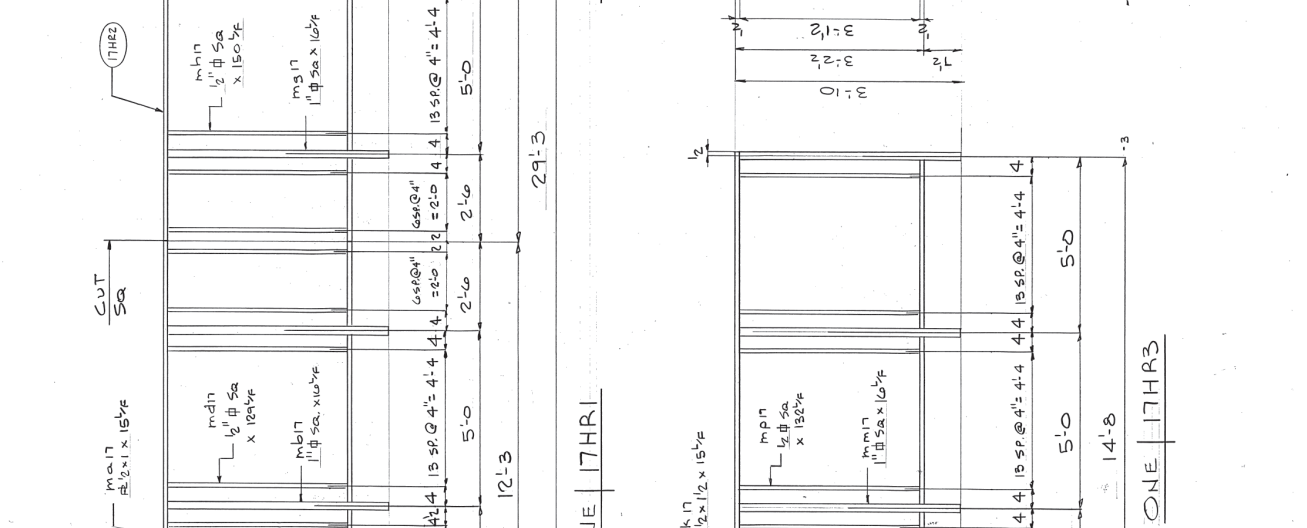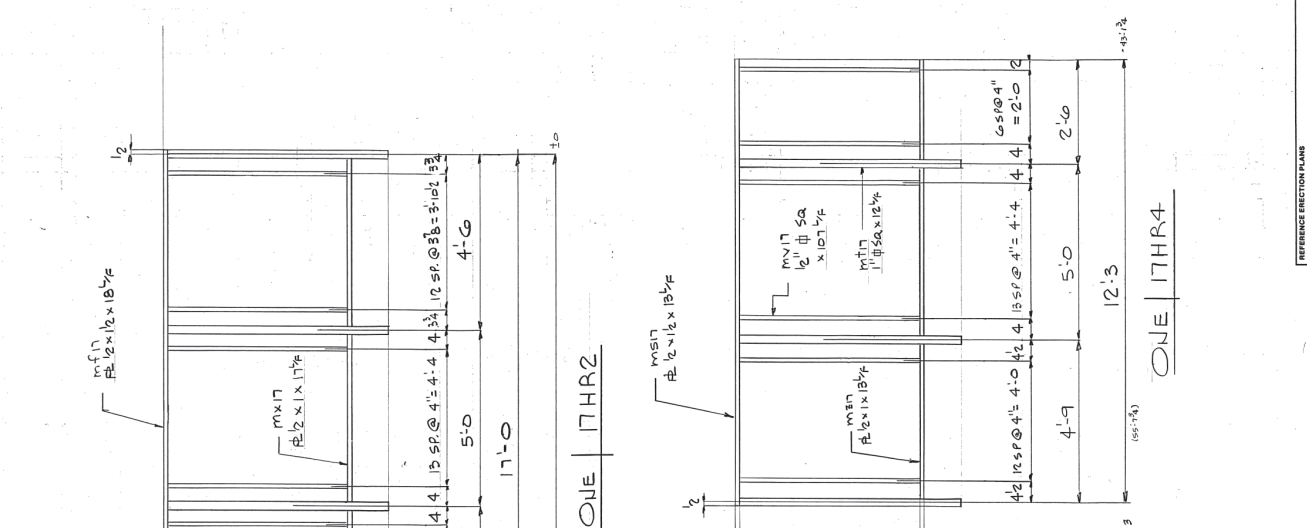

SHOP BILL

NO.	DESCRIPTION	LENGTH FT. IN.	ASSEM. MARK	SHIPPING MARK	REMARKS	WEIGHT
1	HAUDRAIL PS 1 1/2 SCH 40 X 8' X 8'	17	19HR2		1 1/2" O.D.	
1	HAUDRAIL PS 1 1/2 SCH 40 X 8' X 8'	17	19HR2		1 1/2" O.D.	
PROJECT
COUNTY
CITY SCHOOLS

CONTRACTOR
FLAGSTAR CONST.

RETAIL
HAUDRAIL - UPPER SITE RAMP

DRAWN BY
BOB


CHECKED BY
D.T.

DATE
8-15-22

DATE
8-22

9036

19

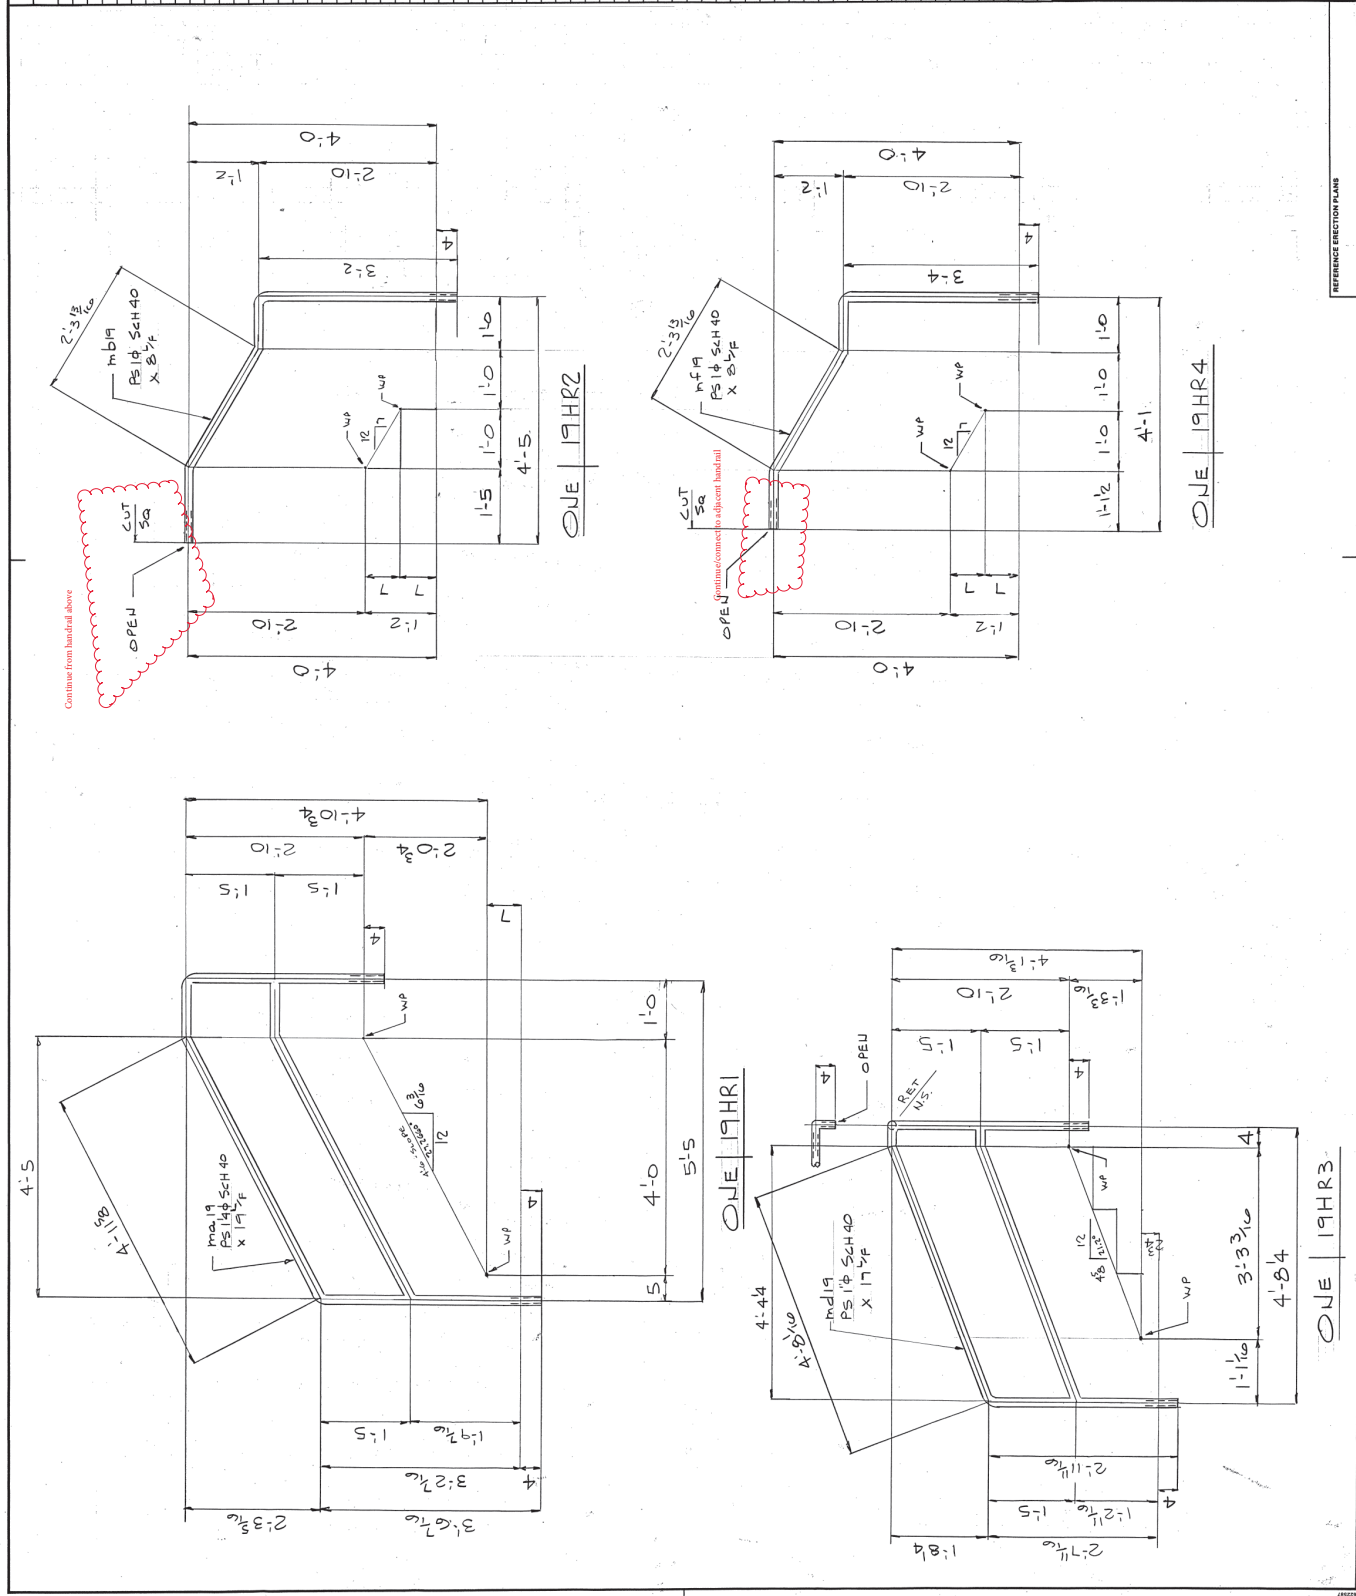


REFERENCE ERECTION PLANS

NOTE


HOLE NUMBER

DATE


BY

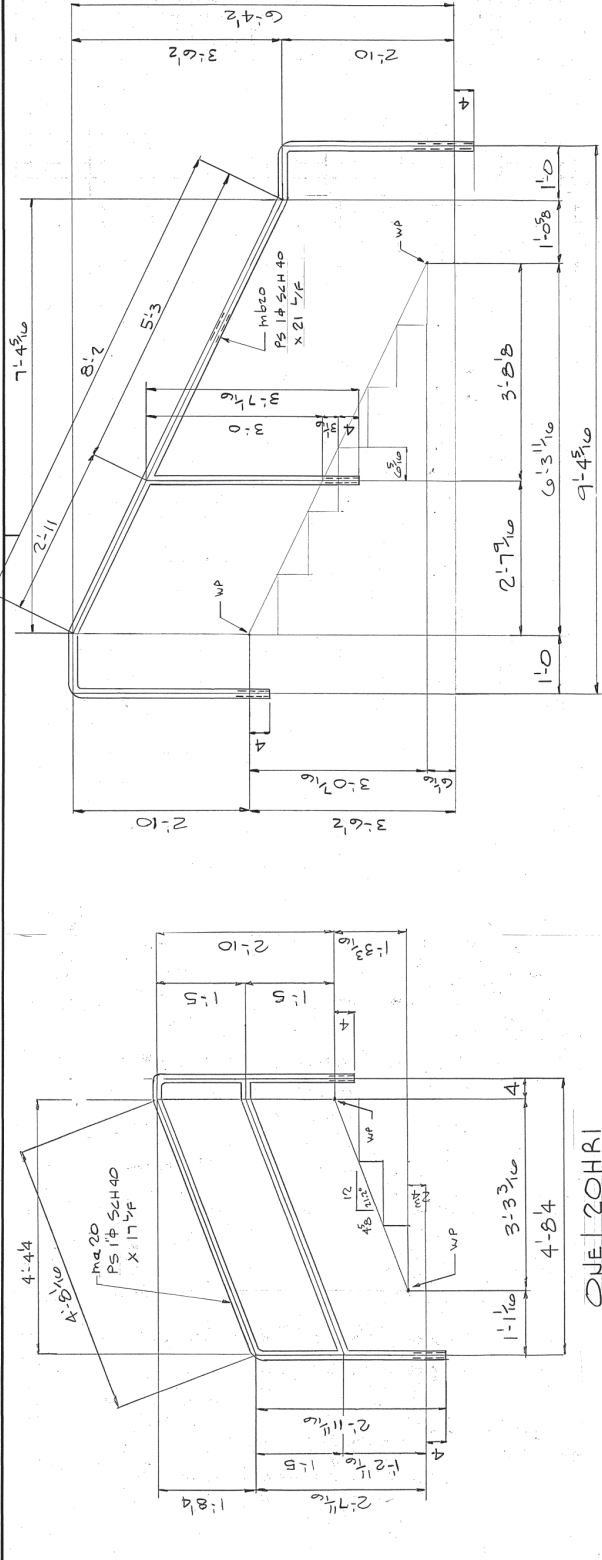


ONE 20HR1

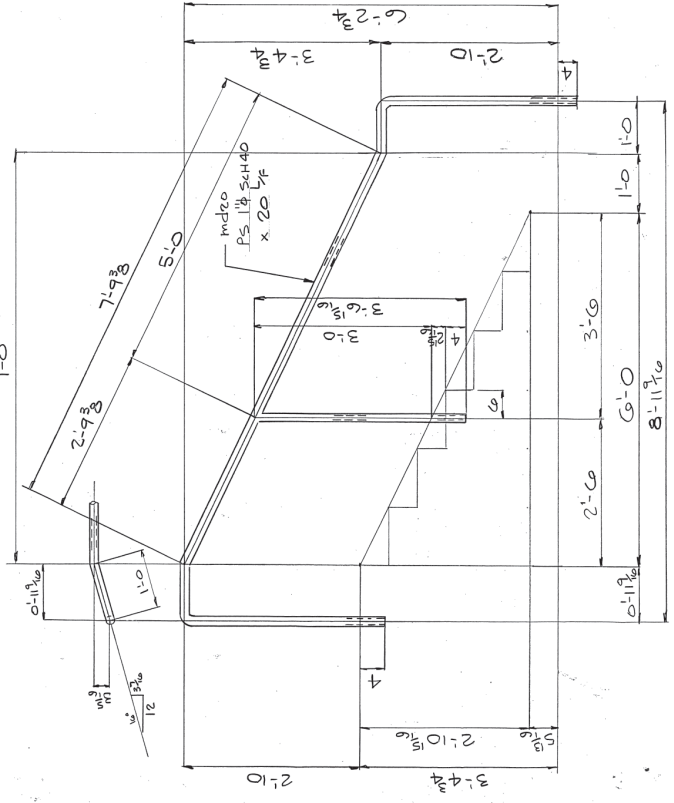

ONE 20HR3

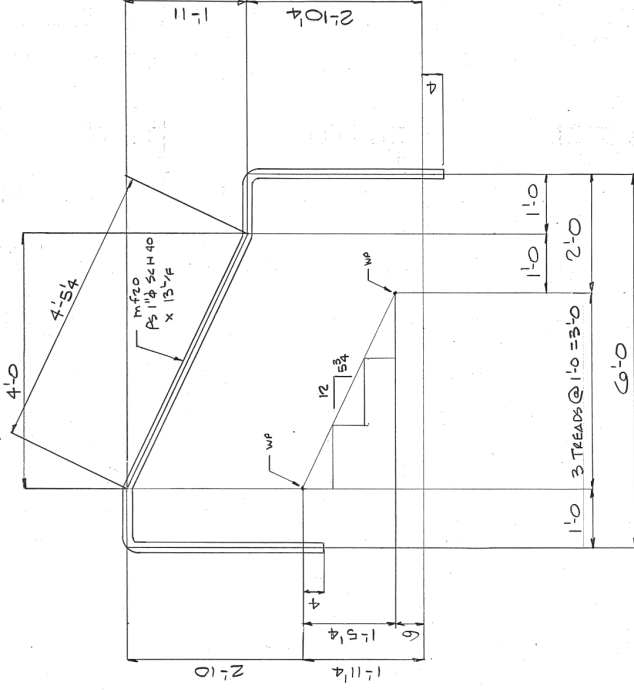

ONE 20HR2

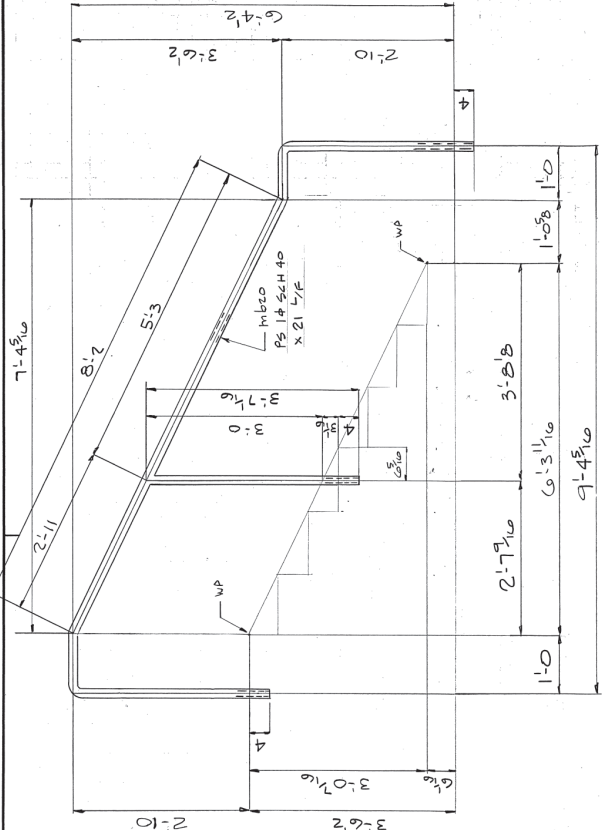

ONE 20HR4

NO.	DESCRIPTION	LENGTH FT. IN.	ASSEMBLY MARK	SHIPPING MARK	REMARKS	WEIGHT
1	HANDRAIL	13'-0 1/2	1/2	20HR1		
1	HANDRAIL	13'-0 1/2	1/2	20HR2		
1	HANDRAIL	13'-0 1/2	1/2	20HR3		
1	HANDRAIL	13'-0 1/2	1/2	20HR4		

NO.	DESCRIPTION	DATE	BY
1	FIELD BOAT SUMMARY THIS SHEET		

REVISIONS	DATE	DESCRIPTION
1		

PROJECT: PORTSIDE CITY SCHOOLS
 DRAWN: BOB
 CHECKED: D.T.
 DATE: 5/22

STRUCTURAL & MISCELLANEOUS FABRICATOR




PART NAME: SHIP CAB
 PRIMER PAINT

MATERIAL GRADE:
 NONE

HOLES:
 NONE

PAGE: 20
 SHEET: 20

NO	DESCRIPTION	LENGTH FT.	ASSEMBLY MARK	SHIPPING MARK	REMARKS	WEIGHT
1	HALF GAL.	15	1/2			
1	RE 1/2 x 1/2	18	1/2			
1	RE 1/2 x 1/2	18	1/2			
1	RE 1/2 x 1/2	18	1/2			
1	PS 1/8 x 1/2	150	1/2			
1	PS 1/8 x 1/2	150	1/2			
1	PS 1/8 x 1/2	150	1/2			
4	ROD 1/2"	12	1/2		BEUT	
21HR2						
1	RE 1/2 x 1/2	18	1/2			
1	RE 1/2 x 1/2	18	1/2			
1	RE 1/2 x 1/2	18	1/2			
1	PS 1/8 x 1/2	150	1/2			
1	PS 1/8 x 1/2	150	1/2			
1	PS 1/8 x 1/2	150	1/2			
1	PS 1/8 x 1/2	150	1/2			
4	ROD 1/2"	12	1/2		BEUT	
21HR3						
1	RE 1/2 x 1/2	18	1/2			
1	RE 1/2 x 1/2	18	1/2			
1	RE 1/2 x 1/2	18	1/2			
1	PS 1/8 x 1/2	150	1/2			
1	PS 1/8 x 1/2	150	1/2			
1	PS 1/8 x 1/2	150	1/2			
1	PS 1/8 x 1/2	150	1/2			
4	ROD 1/2"	12	1/2		BEUT	

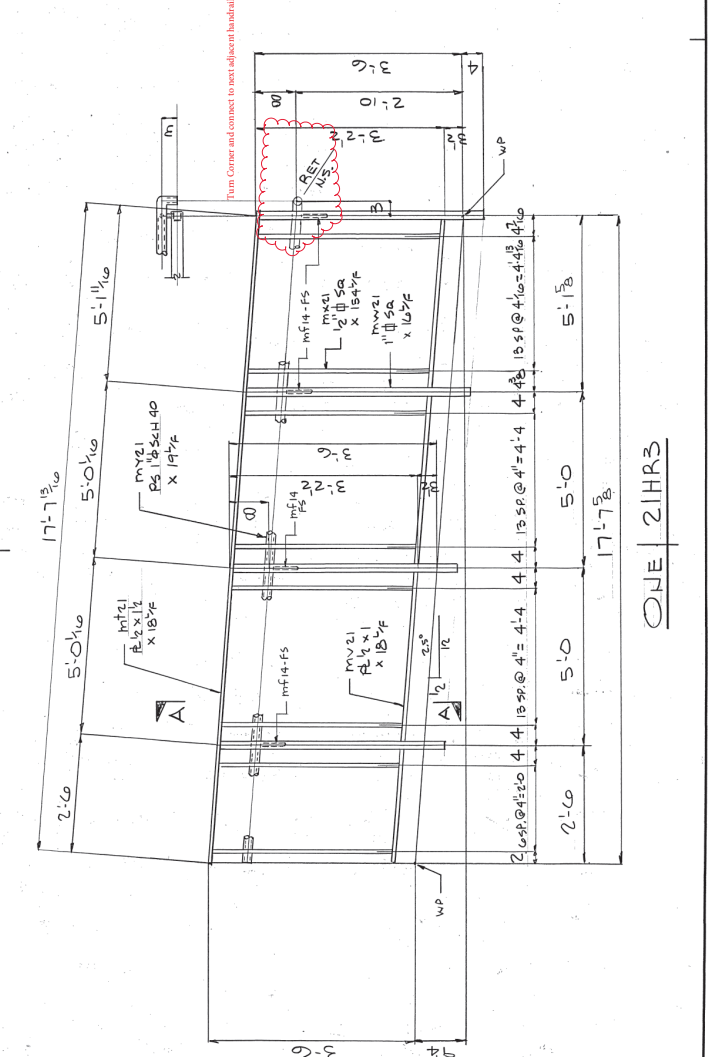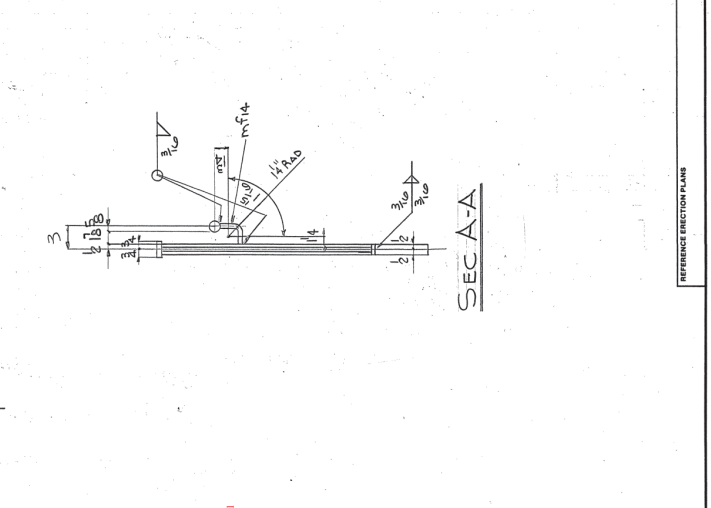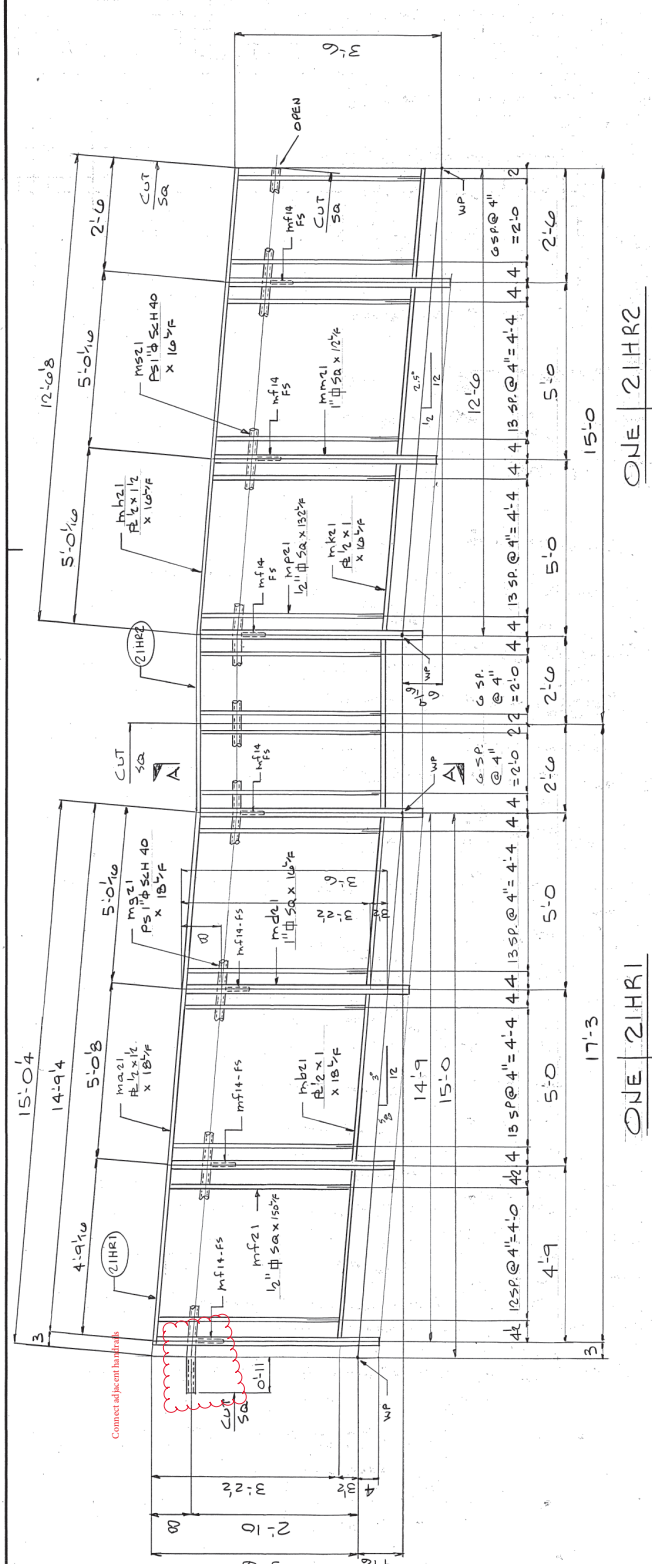

REVISONS		DATE	DESCRIPTION
1			
2			

FIELD NO.	1	2	3
DATE			
DESCRIPTION			

NO.	1	2	3	4	5	6	7	8	9	10	11	12	13	14	15
DATE															
DESCRIPTION															

PROJECT	FOURTEEN CITY SCHOOLS
DRAWN BY	FLUGSTAR CONST.
CHECKED BY	HANDRAIL - UPPER SITE RAMP
DATE	8-16-22
SHOP ORDER NO.	9036
CHECKED BY	9036
DATE	8/22

PAIN ONE SHOP COAT
PRIMER PAINT

MATERIAL QUANTITY LIST

CLEANING

NOLES NONE

REFERENCE SECTION PLANS

SHOP BILL

NO.	DESCRIPTION	ASSEMBLY	SHIPPING MARK	REMARKS	WEIGHT
1	1" x 1/2" SCH 40	40	22HR1		
2	1" x 1/2" SCH 40	40	22HR2		
3	1" x 1/2" SCH 40	40	22HR3		
40	1" x 1/2" SCH 40	40	22HR40		




REVISIONS

NO.	DATE	DESCRIPTION
1		
2		
3		
FIELD BOLT SUMMARY THIS SHEET

NO.	DATE	DESCRIPTION
1		
2		
3		
PROJECT: BUNDTAC CITY SCHOOLS
DETAIL: FLAGSTAR CONST.
DRAWN BY: [Signature]
CHECKED BY: [Signature]
DATE: 8/22
SHOP ORDER NO.: 9036
SHEET NO.: 22

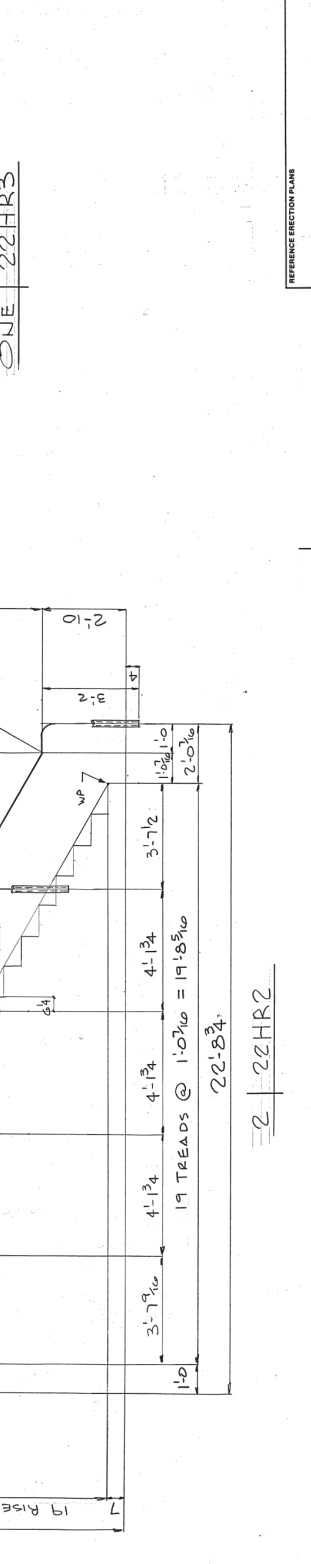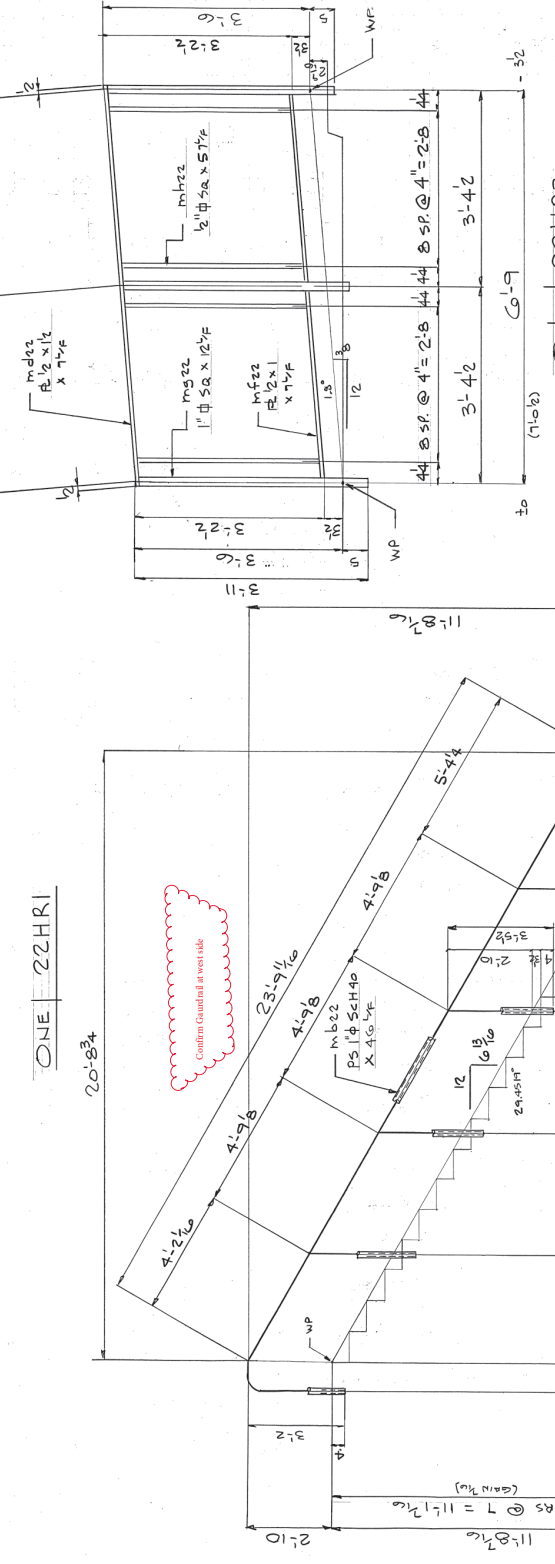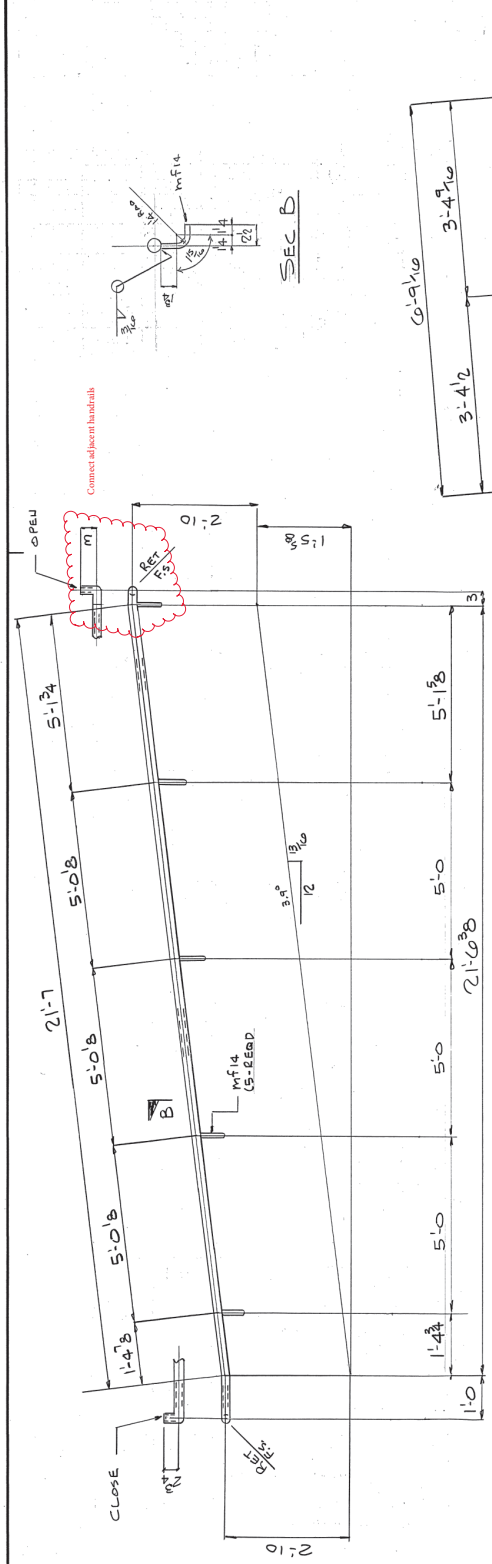

STRUCTURAL & MISCELLANEOUS FABRICATOR

PROJECT: BUNDTAC CITY SCHOOLS
DETAIL: FLAGSTAR CONST.
DRAWN BY: [Signature]
CHECKED BY: [Signature]
DATE: 8/22
SHOP ORDER NO.: 9036
SHEET NO.: 22

NO.	DESCRIPTION	LENGTH FT. IN.	ASSEMBLY MARK	SHIPPING MARK	REMARKS	WEIGHT
1	HANDRAIL PS 1 1/8 SCH 40	12	mf23	23HR1	186.00	
1	HANDRAIL PS 1 1/8 SCH 40	23	mf23	23HR2		
1	HANDRAIL PS 1 1/8 SCH 40	34	mf23	23HR5		
1	HANDRAIL PS 1 1/8 SCH 40	23	mf23	23HR4		
1	HANDRAIL PS 1 1/8 SCH 40	30	mf23	23HR5		
1	WALL RAIL PS 1 1/8 SCH 40	14	mf23	23HR6		
1	WASHER M18x1.5	4	mf23	23HR7		

REVISIONS

NO.	DATE	DESCRIPTION
1	12/28/23	ISSUE
2	1/10/24	REVISED
3	1/10/24	REVISED

PROJECT SUMMARY SHEET

PROJECT: PONTIAC CITY SCHOOLS
 CUSTOMER: FLAGSTAR CONST.
 SHEET: 23
 DATE: 8/21

DETAIL: HANDRAIL - UPPER SITE RAMP

PROJECT: PONTIAC CITY SCHOOLS
 CUSTOMER: FLAGSTAR CONST.
 SHEET: 23
 DATE: 8/21

MATERIALS

PS 1 1/8 SCH 40
 M18x1.5
 M18x1.5

PAINT

PRIMER PAINT
 SHOP COAT

CLEANING

WIPER

HOLES

NONE

REFERENCE ERECTION PLANS

ONE 23HR1
 ONE 23HR2
 ONE 23HR4
 ONE 23HR5

